

MARION COUNTY SURVEYOR'S OFFICE



SECTION CORNER RECORD

DEBRA S. JENKINS
MARION COUNTY SURVEYOR

SEC. 17 TWN. 14_N RNG. 5_E

BRYAN F. CATLIN, PS
TECHNICAL SUPERVISOR

Date: 7/8/2015
Party Chief: Greene
Crew: Wilburn
Type of Marker: Harrison
Method of Establishment: County: 1/17/1995
IN S.P.C. E Zone, NAD 83 (1986)
Name: 14051704
N: 489 780. 426 (m)
E: 70 618. 956 (m)

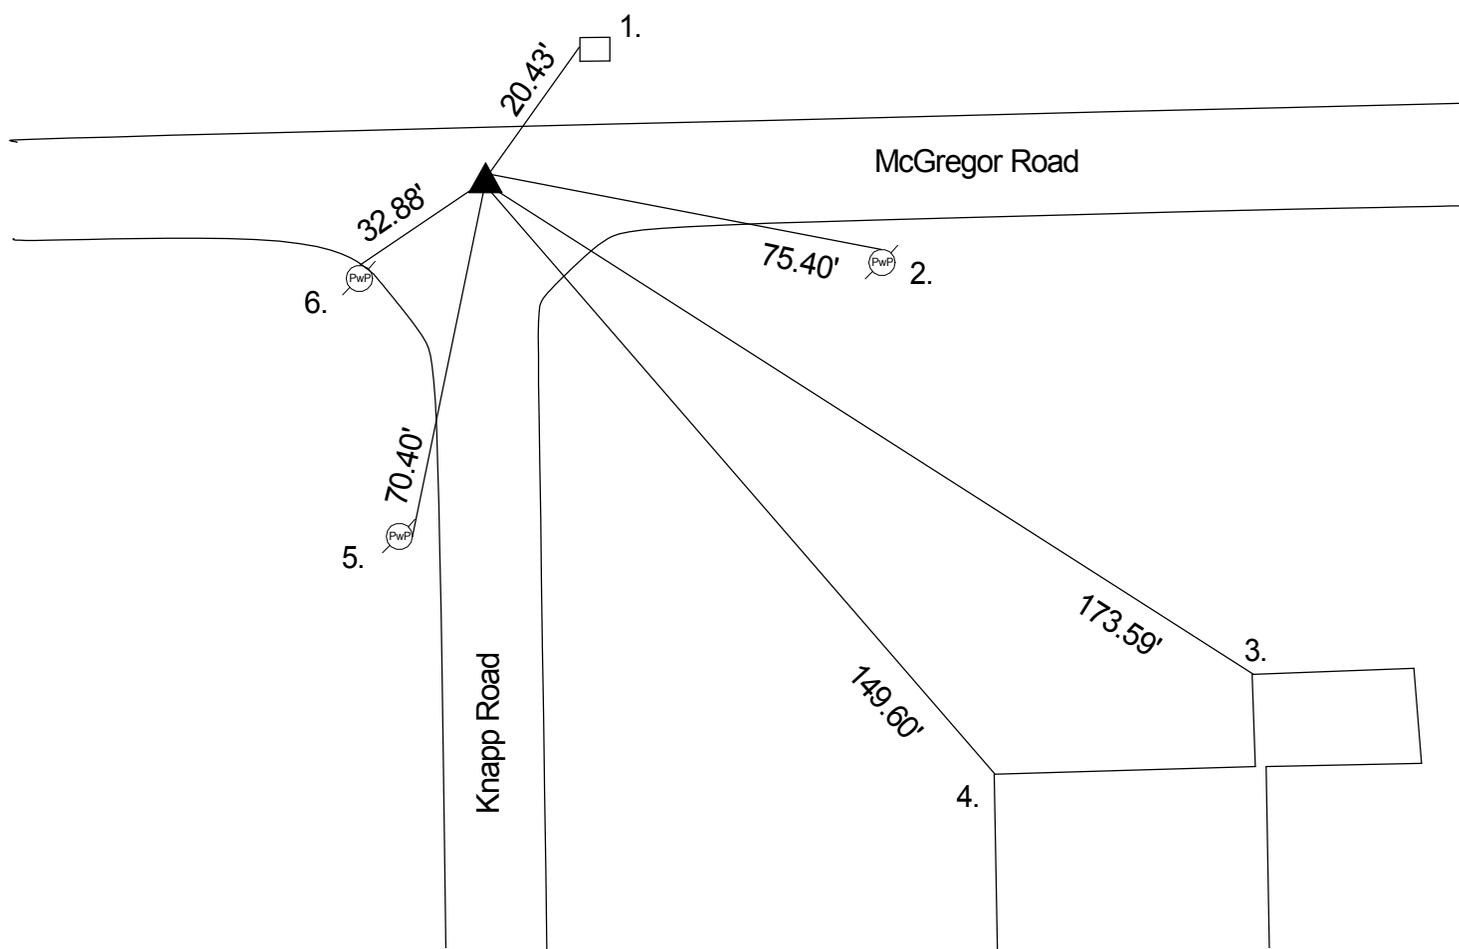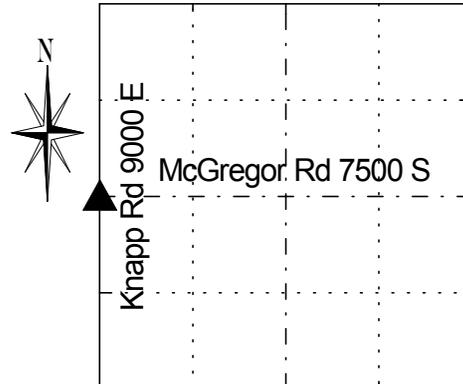

Original post set in 1820 by John Hendricks with witnesses: 14" (10"?) Sugar N 30°E 11 links, 6" Beech S 45°W (E?) 11 links (Marion County Atlas pg. 13). D.B. Hosbrook 2/18/1852 noted corner with witnesses: 5" Beech S 23°E 32 links, 12" Beech S 45°E 10 ½ links (Franklin Twp. Legal Survey Book pg. 40). W.C. Smith 5/23/1887 noted distance to corner (Franklin Twp. Legal Survey Book pg. 59). N.C. Thompson 2/1/1944 found Stone with cap on top 2" down. MCSO undated did not specify monument. McLand 5/10/1971 called Stone 4" down. T. Fortner 12/2/1974 called PK at surface over Stone 4" down. Greene 6/26/1986 called PK at surface over Stone 4" down. Greene 10/16/1990 excavated, found PK Nail at surface, found Stone 4" down with wooden hubs on both sides, found Stone 10" down on its side, set Harrison. Whiteside 1/17/1995 called Harrison. Wilcoxon 4/26/2000 called Harrison. Wilcoxon 1/10/2005 called Harrison. Wilcoxon 1/16/2007 found Harrison. Greene 7/8/2015 replaced broken Harrison with new Harrison.

REF	DISTANCE	DESCRIPTION
1.	20.43'	PK Nail W corner fence post 6" up
2.	75.40'	MAG Nail w/ brass washer N PwP #164-801-A 12" up
3.	173.59'	NW Corner Wood Barn 24" up
4.	149.60'	NW Corner Wood Barn 24" up
5.	70.40'	MAG w/ brass washer Nail E PwP #4-801 12" up
6.	32.88'	MAG w/ brass washer Nail N PwP #003-801A 12" up